




VALVES
 #1 = Zone 1
 #2 = Zone 2
 #3 = Zone 3

NOTES
 IRRIGATION SYSTEM WILL HAVE THREE (3) ZONES

 ZONE 1
 BLOCK 1
 LOTS 1-13
 ZONE 2
 BLOCK 1
 LOTS 14-16
 BLOCK 3
 LOTS 1-8
 ZONE 3
 BLOCK 2
 LOTS 1-14



ZONE 1, BLOCK 1
 LOTS 1-3

ZONE 2, BLOCK 1
 LOTS 14-16
BLOCK 3
 LOTS 1-8


ZONE 3, BLOCK 2
 LOTS 1-14

USE #2 LOCATION


= DISCHARGE LOCATIONS

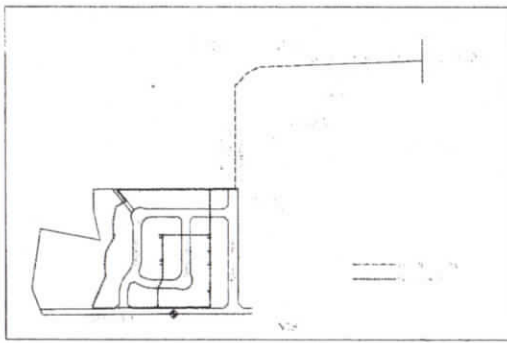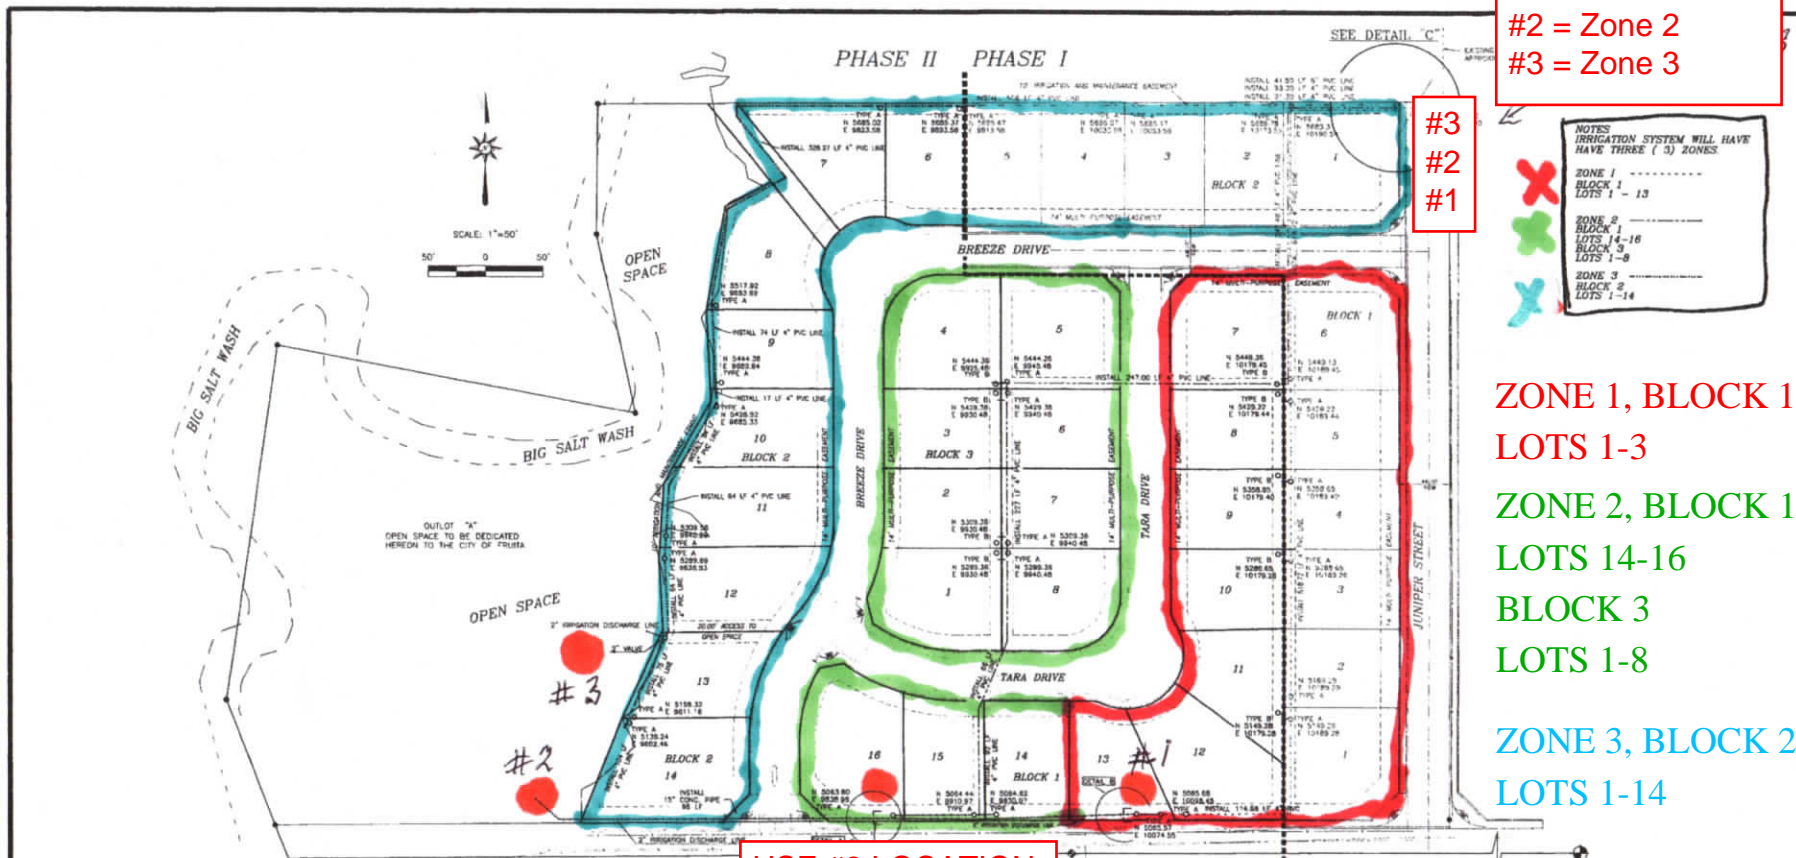


OFF-SITE IRRIGATION PLAN

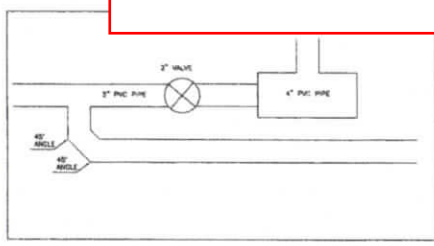

IRRIGATION DETAIL A

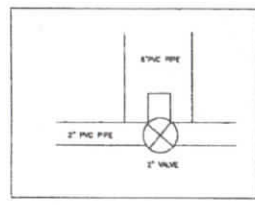

IRRIGATION DETAIL B

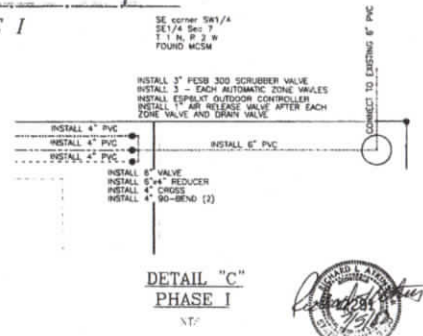

DETAIL "C"
 PHASE I

DATE	REVISION	BY

DRAWN BY:	DC	SCALE: 1" = 40'
CHECKED BY:	RA	SCALE: 1" = 40'
DATE:	11/23/09	HORZ: 1" = 40'
PROJECT NO.:	98011	VERT: 1" = 40'
FILE NAME:	9810-12-21	

IRRIGATION PLAN

PHASE II
 EVENING BREEZE
 SUBDIVISION

ATKINS AND ASSOCIATES, INC.
 P. O. BOX 2702, 518 28 ROAD, SUITE H 105
 GRAND JUNCTION, COLORADO 81502
 970-245-8650 FAX 970-245-2355

SHEET
 10
 OF
 15

RECORD DRAWING SH 10 OF 10